

	•	1
	ENGINEERING CHANGE NOTICL NO. 01926 SHEET 1	□F 1
APICAL	DWG NO. 41228-301-087 REV: IR PREPARED D.BARKER DATE: 08/28/07 OIN	CT ON DWG C. XI UNINC.
INDUSTRIES, INC.	DWG TITLE: PRESSURE SWITCH ANGLE ASSY	
	APPROVED BY, ENGR COS and MFG W. J. QC CORREN	T ORDER
TRANSACTION CODES (TC): A-ADD C-CREATE R-REVISE D-DELETE	REASON: UPDATED PARTS LIST	

## CONTROL COPY ISSUED DATE

SEP 0 4 2007

8	R	MS29512-08	6	O-RING						
			-001							
F/N	TC	PART NUMBER	QTY	NAME			STOCK SIZE	MATERIAL	MATL.SPEC	ZONE
DOCUMENTS EFFECTED:				☐ MDL	☐ INSTALL INSTRUC	□ ICA	IANGE CATEGORY MAJOR ☒ MINO		IEW REQUIRED S 🛛 NO	

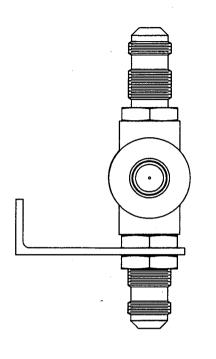

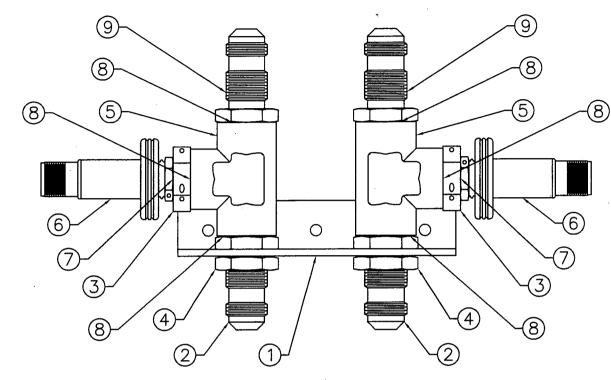

## UNINCORPORATED ECN(s)

01926,

-001 MOUNTING ANGLE ASSY

				2	9	20C8A	СН	ECK VALV	Έ	AUT	J-VAL\	/E, D/	AYTON, C	HIO		
				4	8	MS29512-08	0-	RING								
				2.	7	MS29512-04	0-	RING								
				2	6	1103P0553	PRI	ESSURE S	SWITCH							
				2	5	AN938-8D	TEE	<u> </u>								
			2 4 AN924-8D 2 3 AN893-3D				ΝÚ	T								
							REI	DUCER								
				2	2	AN832-8D	FIT	TING								
				1	1 1 41228-301-086-00		MOUNTING ANGLE			· · · · · · · · · · · · · · · · · · ·						
				$\overline{A}$		-001	ASS	SY								
				-001	FIND NO.	PART NO.		NAME			STOCK S	SIZE	MATER	RIAL	MATL.SPEC	ZONE
	NO.	REQ'D	PE	R AS	SY			LIS	ST OF	MATE	RIAL		,			
RIG	OPRIE HTS N	OTICE						UNLESS OTHERWISE SPECIFIED	DRFTSMN CHECK	D. N	ELSON	10/8/01	TITLE		SURE SWITC	Н
DISCL	ESE DATA ROPRIETAR AVIATION LOSURE,	n, INC. REPRO—					<del> </del>	X.±.1 XX.±.03	STRESS					AN	NGLE ASSY	
THES PURP DEN	DUCTION, OR USE OF THESE DATA FOR ANY PURPOSE IS FORBID- DEN WITHOUT WRITTEN AUTHORIZATION FROM ETA AVATION, INC. THE FOREGOING DOES NOT APPLY TO VENDOR PARTS.		-001	1	11	228-300-009	-	XXX.±.010 ANGLES	PROJ. ENGR. HEAT TREAT		1		DWG. SIZE	Ç	SCALE NON	E REV.
ERA THE			DASH NO.	REGYD PER ASSY	<del>-+</del> 1.	NEXT ASSEMBLY	MOL	±.1/2	FINISH		Era	Avi	ation,	Inc.	41228-301-	087   IR